



(2 PLACE TOLERANCES APPLY FOR THIS VIEW)

SCALE 1/2

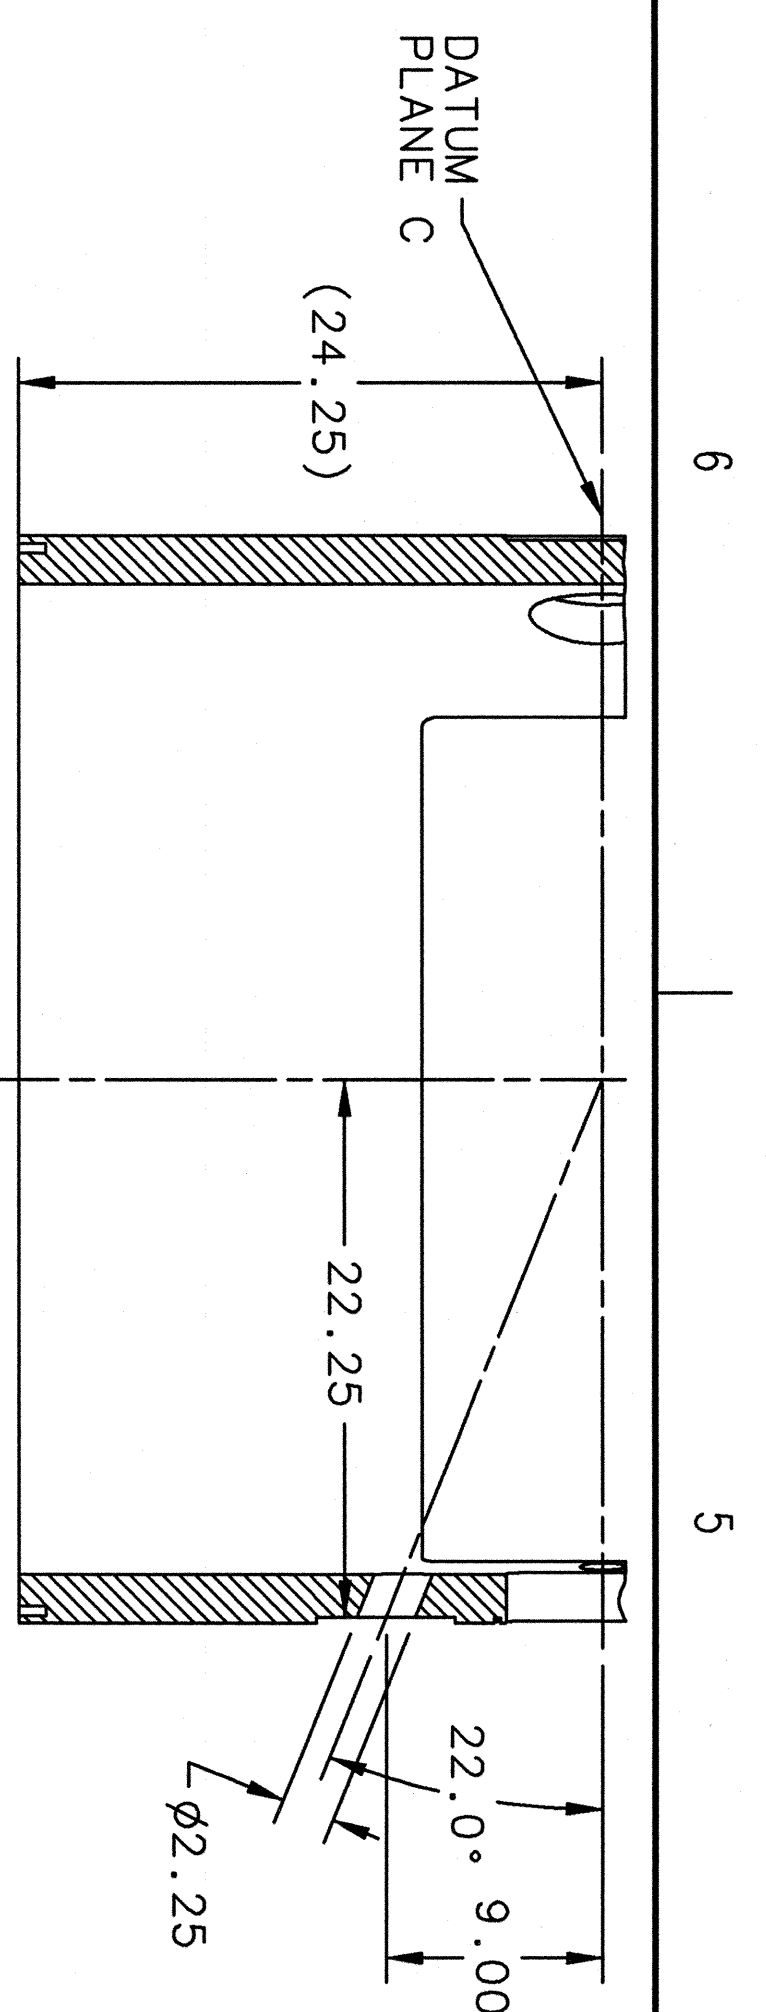


SECTION D-1
2 PLACES
(VIEW ROTATED)

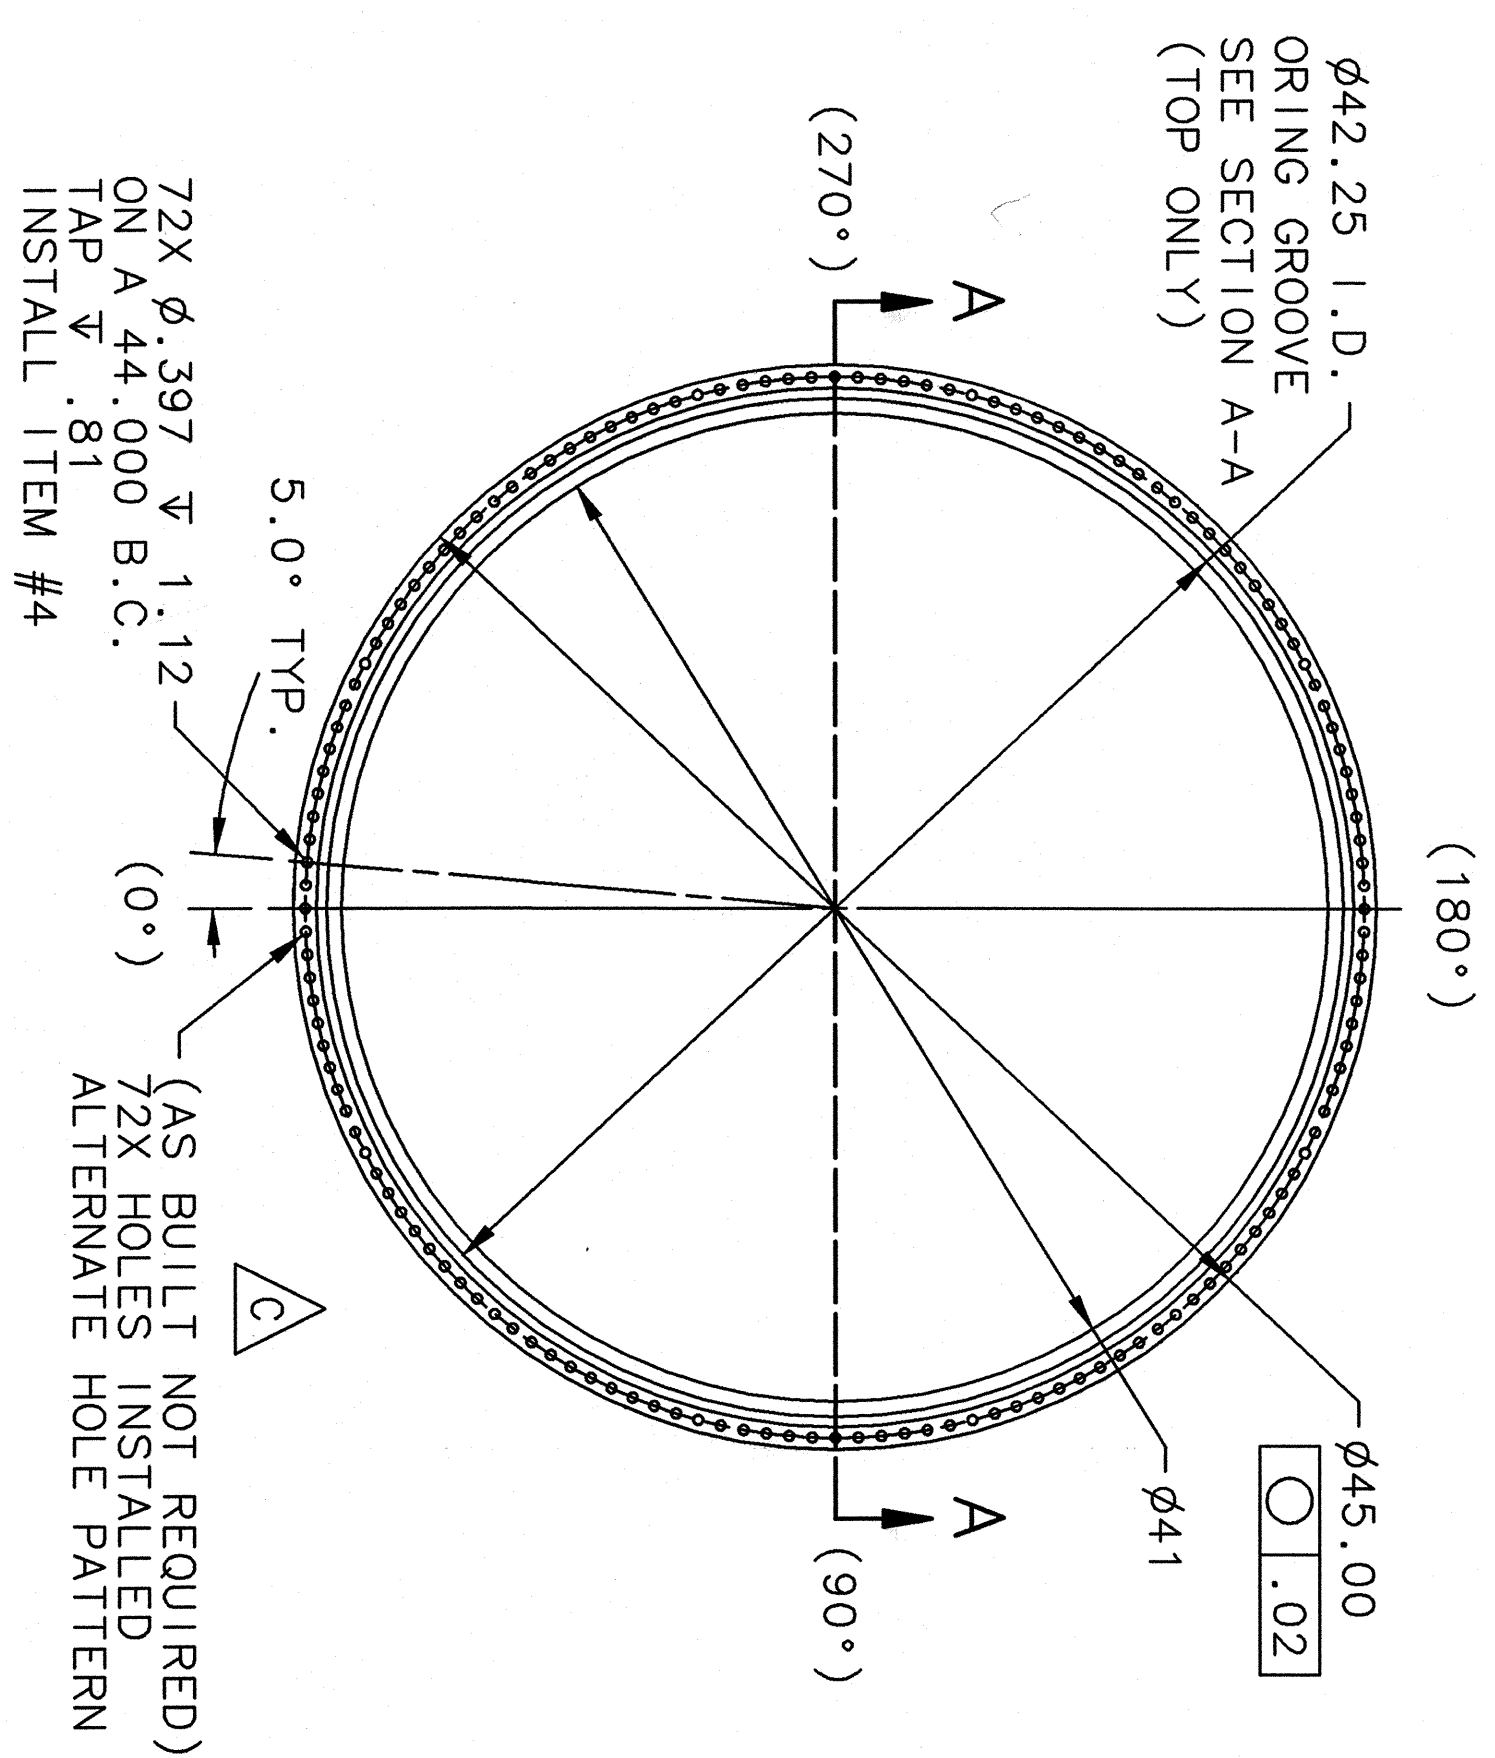


72X Ø.337 V 1.12 (0°) (AS BUILT NOT REQUIRED)
ON A 44.000 B.C. 72X HOLES INSTALLED
TAP V .81 ALTERNATE HOLE PATTERN
INSTALL ITEM #4

TOP VIEW

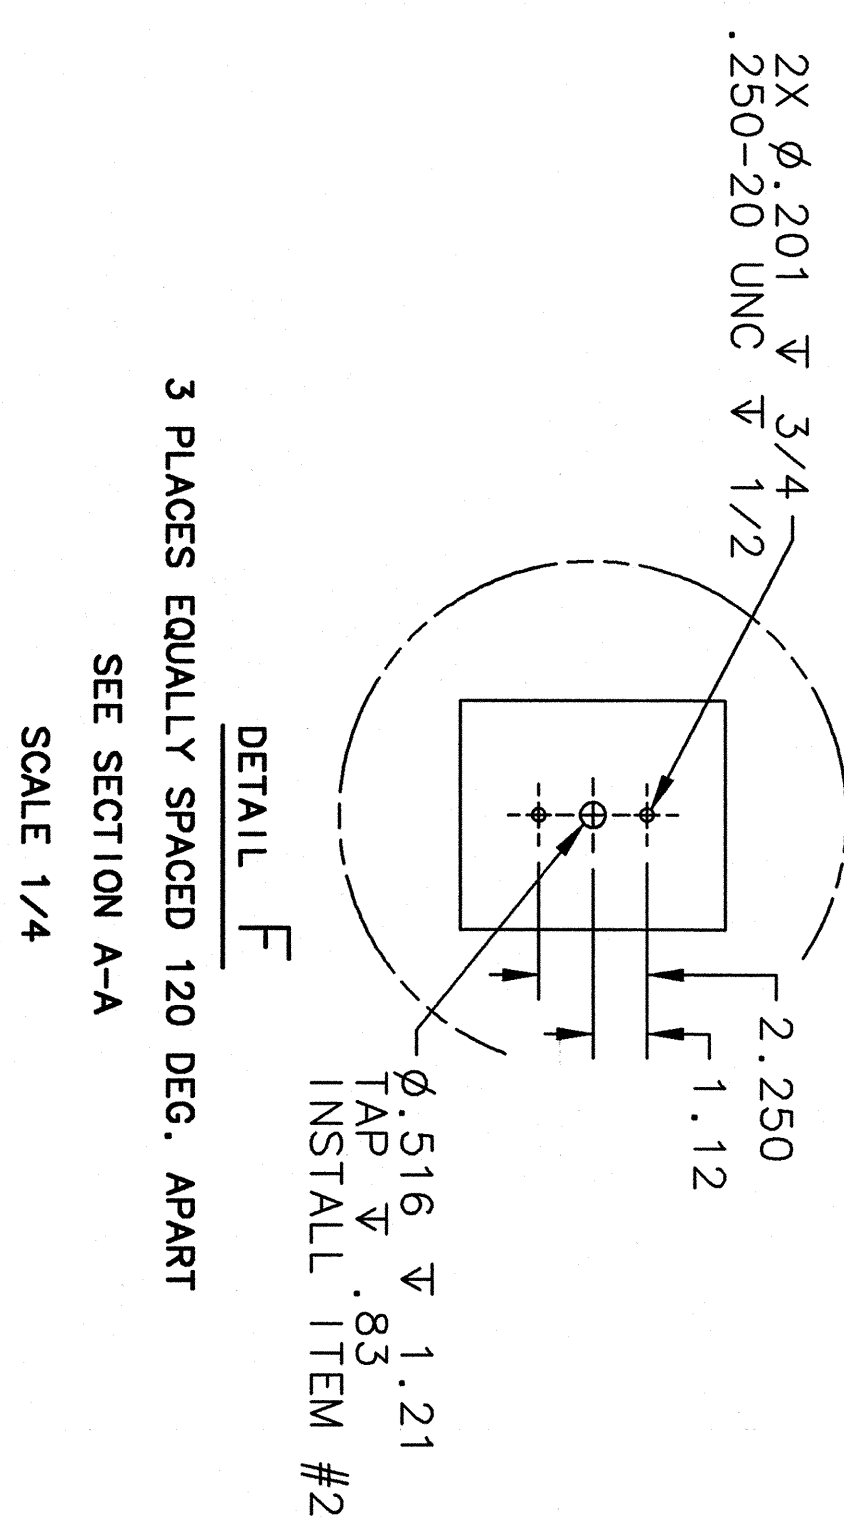


3 PLACES EQUALLY SPACED 120 DEG. APART
SEE SECTION A-A
SCALE 1/4"

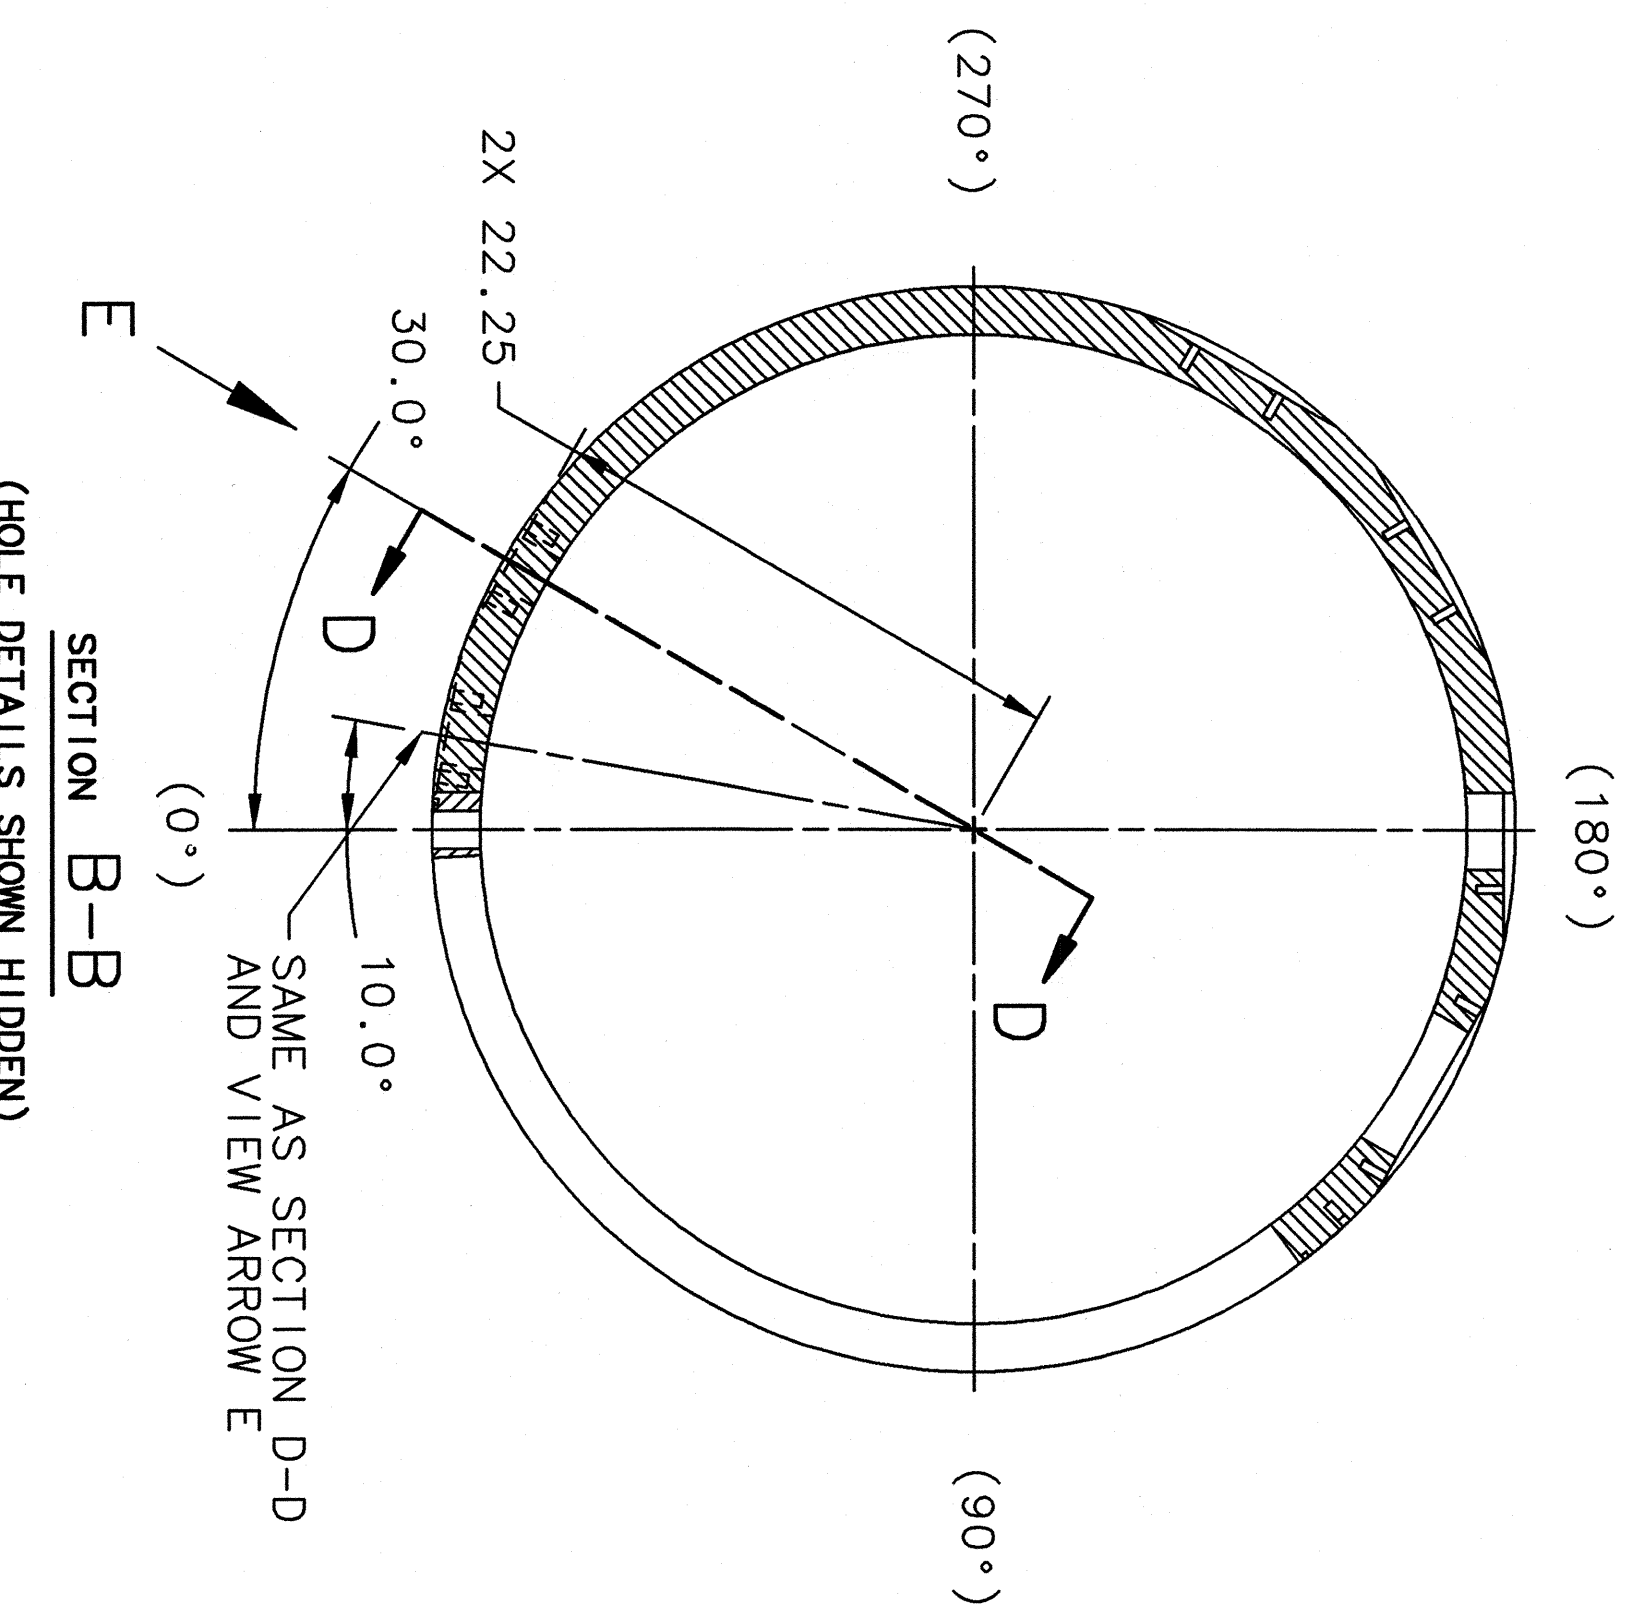


SECTION B-B

(HOLE DETAILS SHOWN HIDDEN)

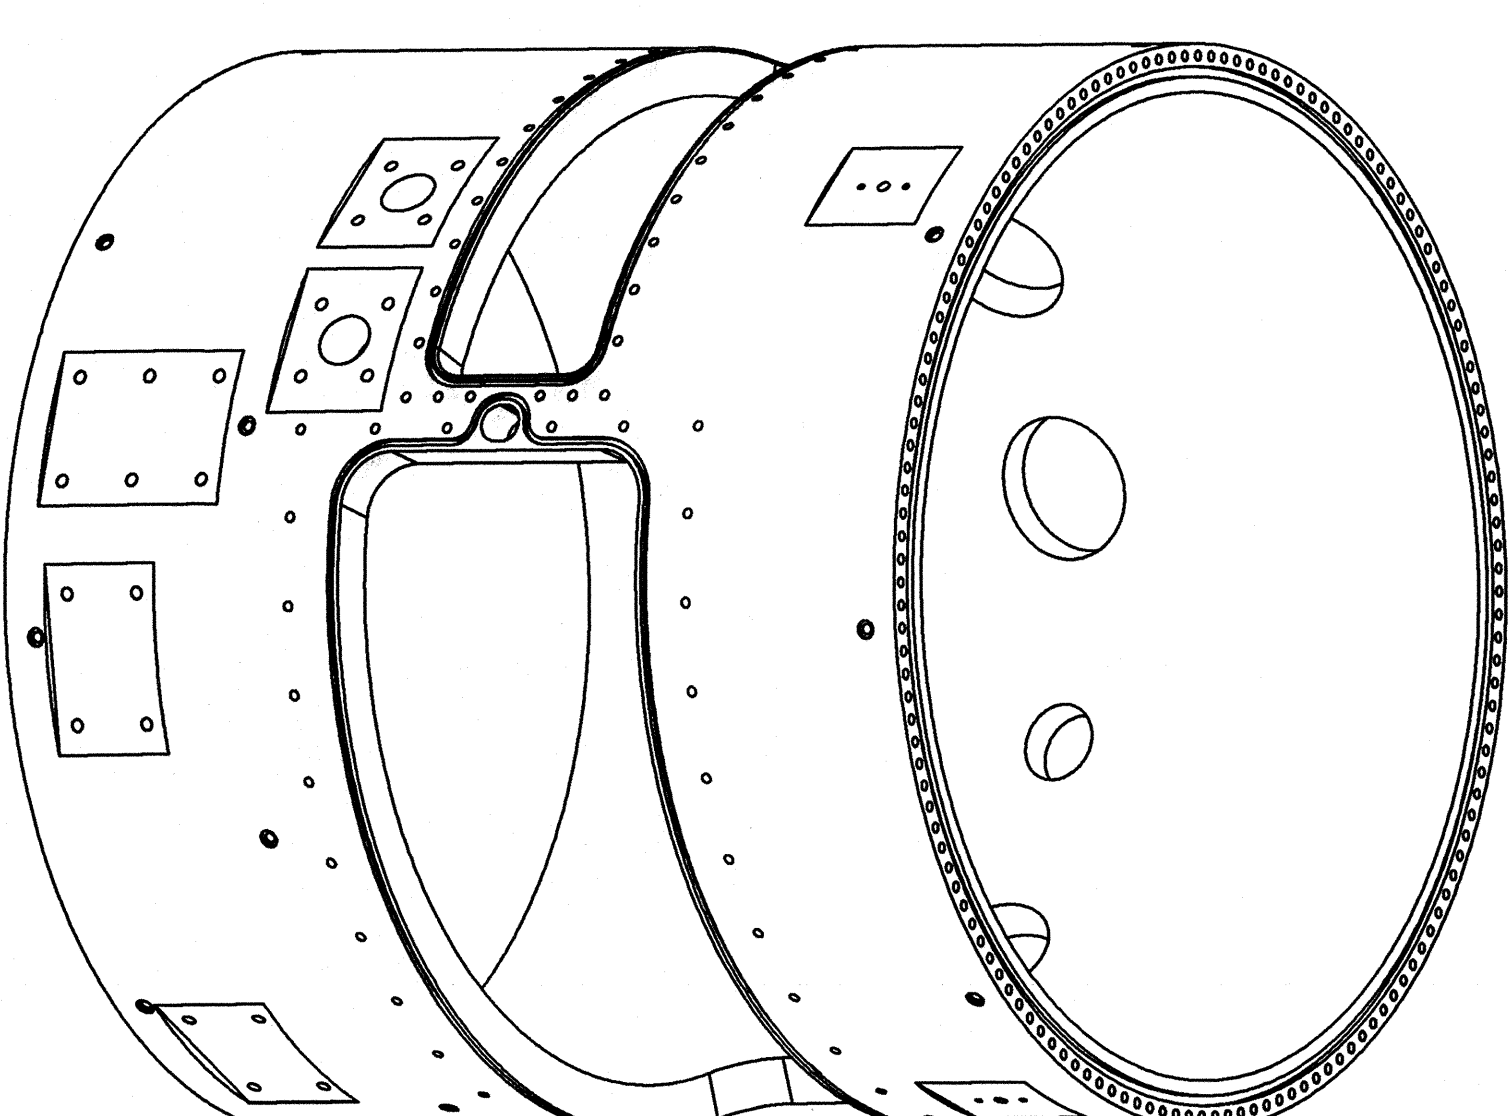


REVISION HISTORY		
ZONE	REV	DATE
-	A	7-05-06
TITILE BLOCK TOLERANCE CHANGE		
B		8-09-06
ADDED DIMENSIONS		
-	C	1-04-07
ADDED DIMENSIONS (UPDATED VIEWS TO AS BUILT)		
		B.C.M.
		B.C.M.

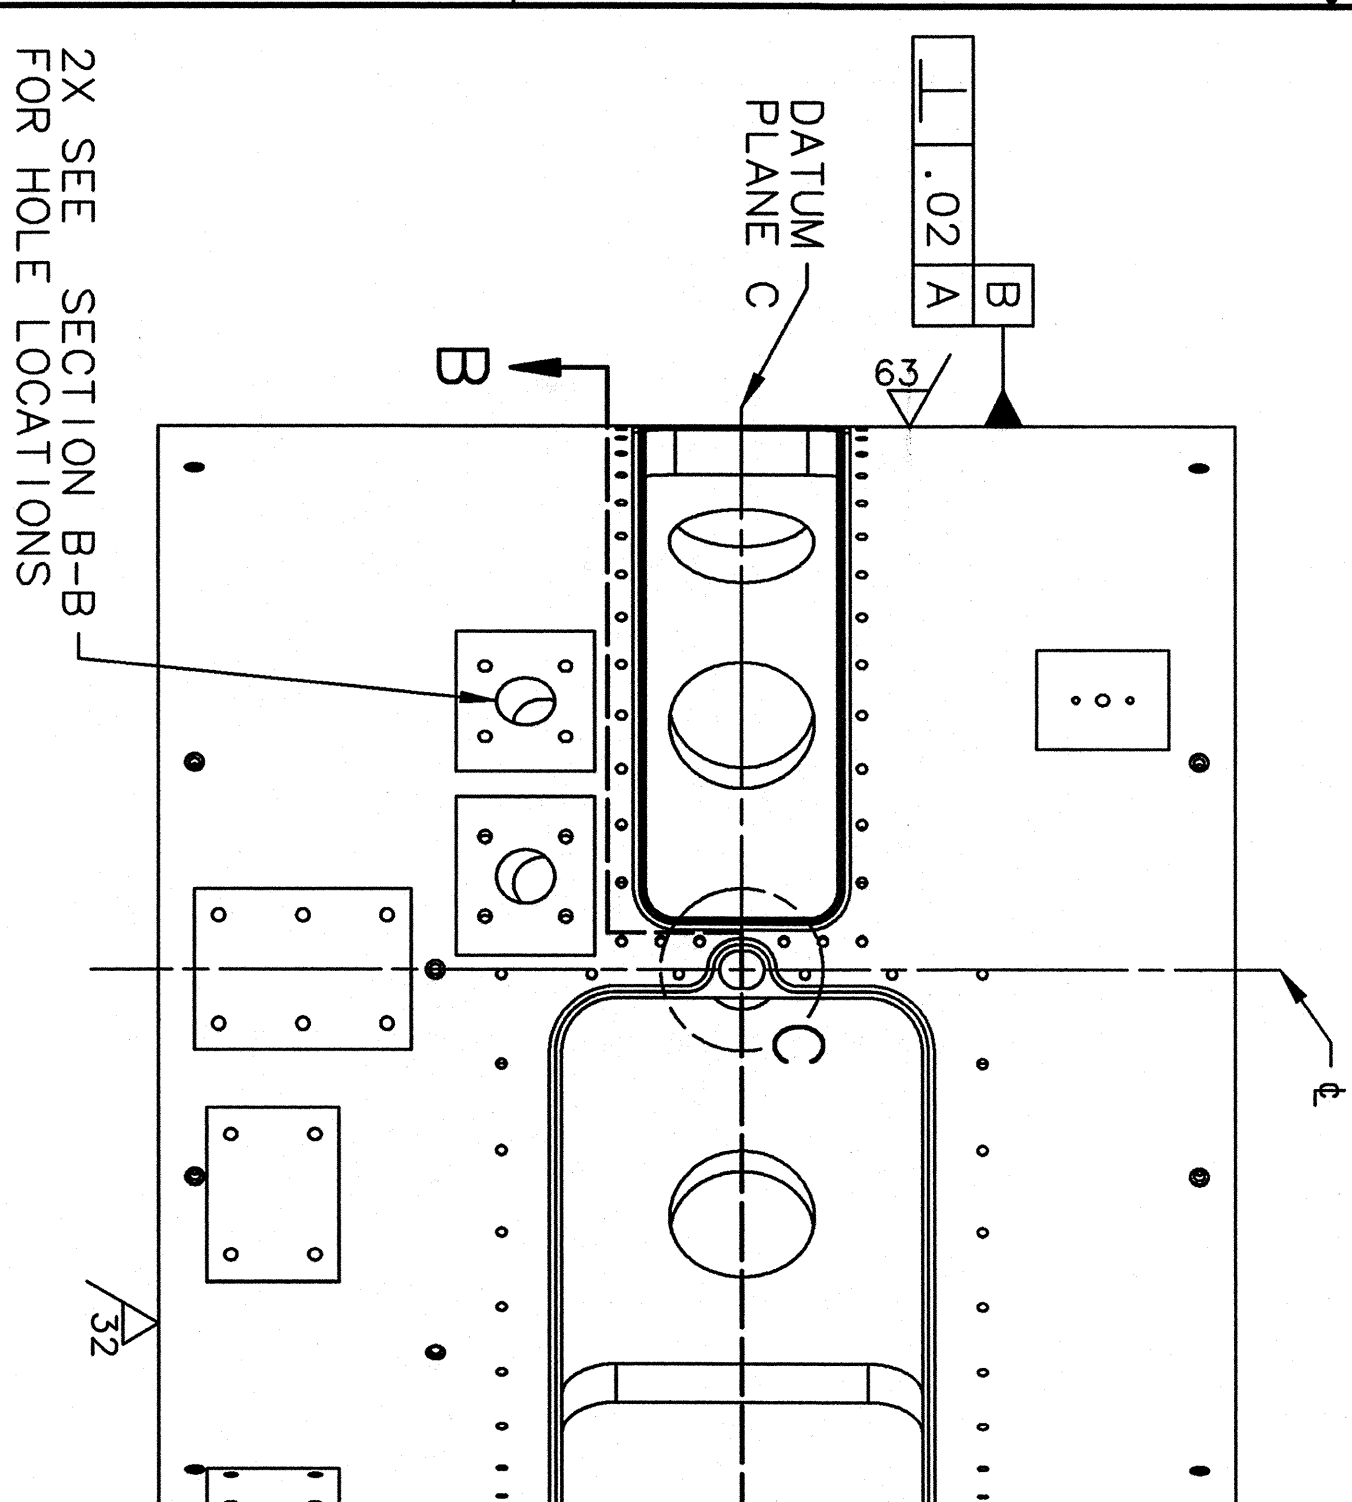


FOR HOLE LOCATIONS

FRONT VIEW

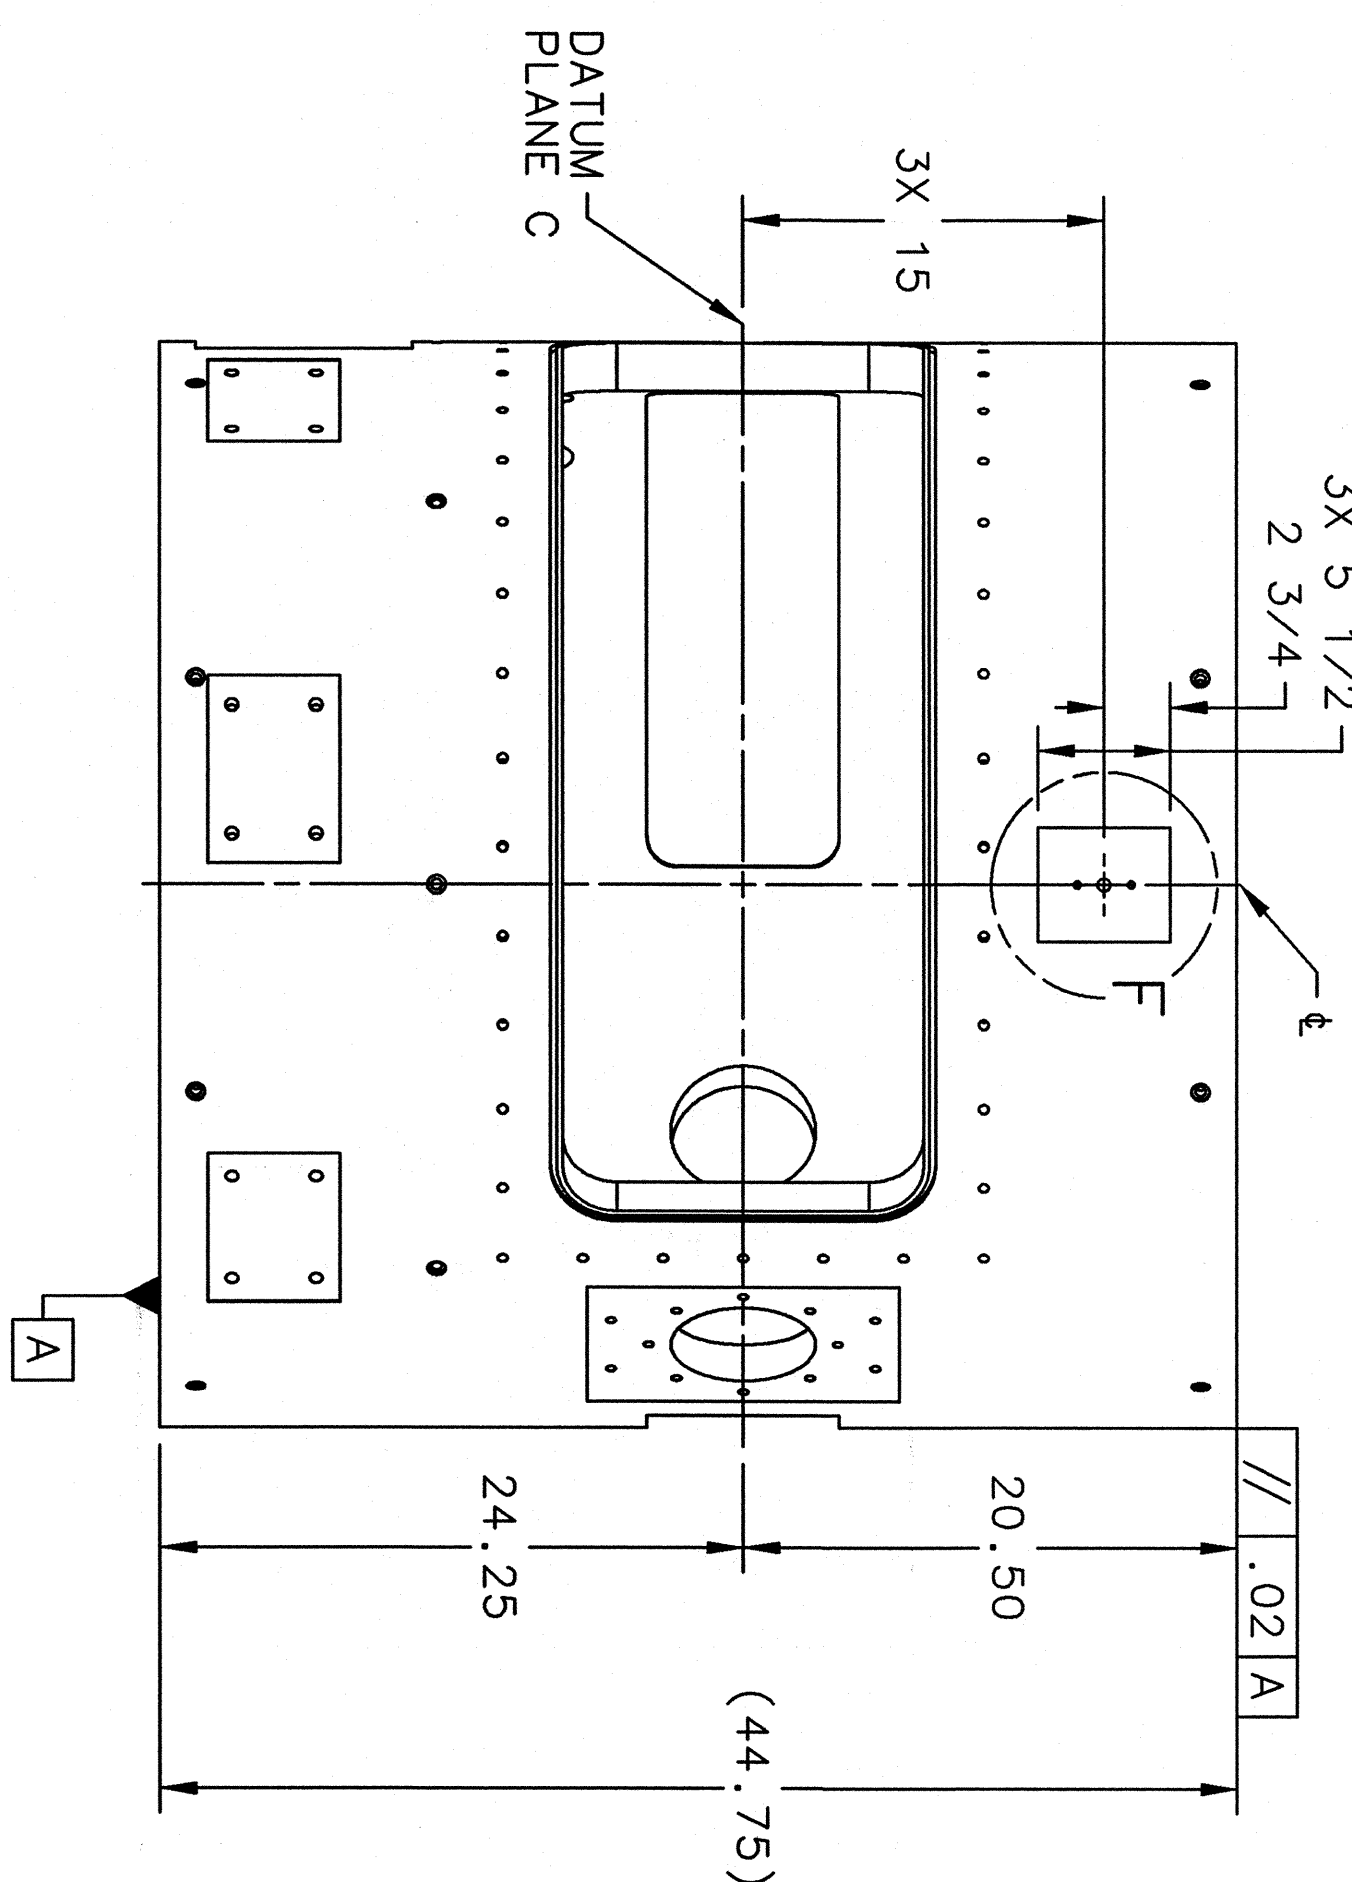


SIDE VIEW

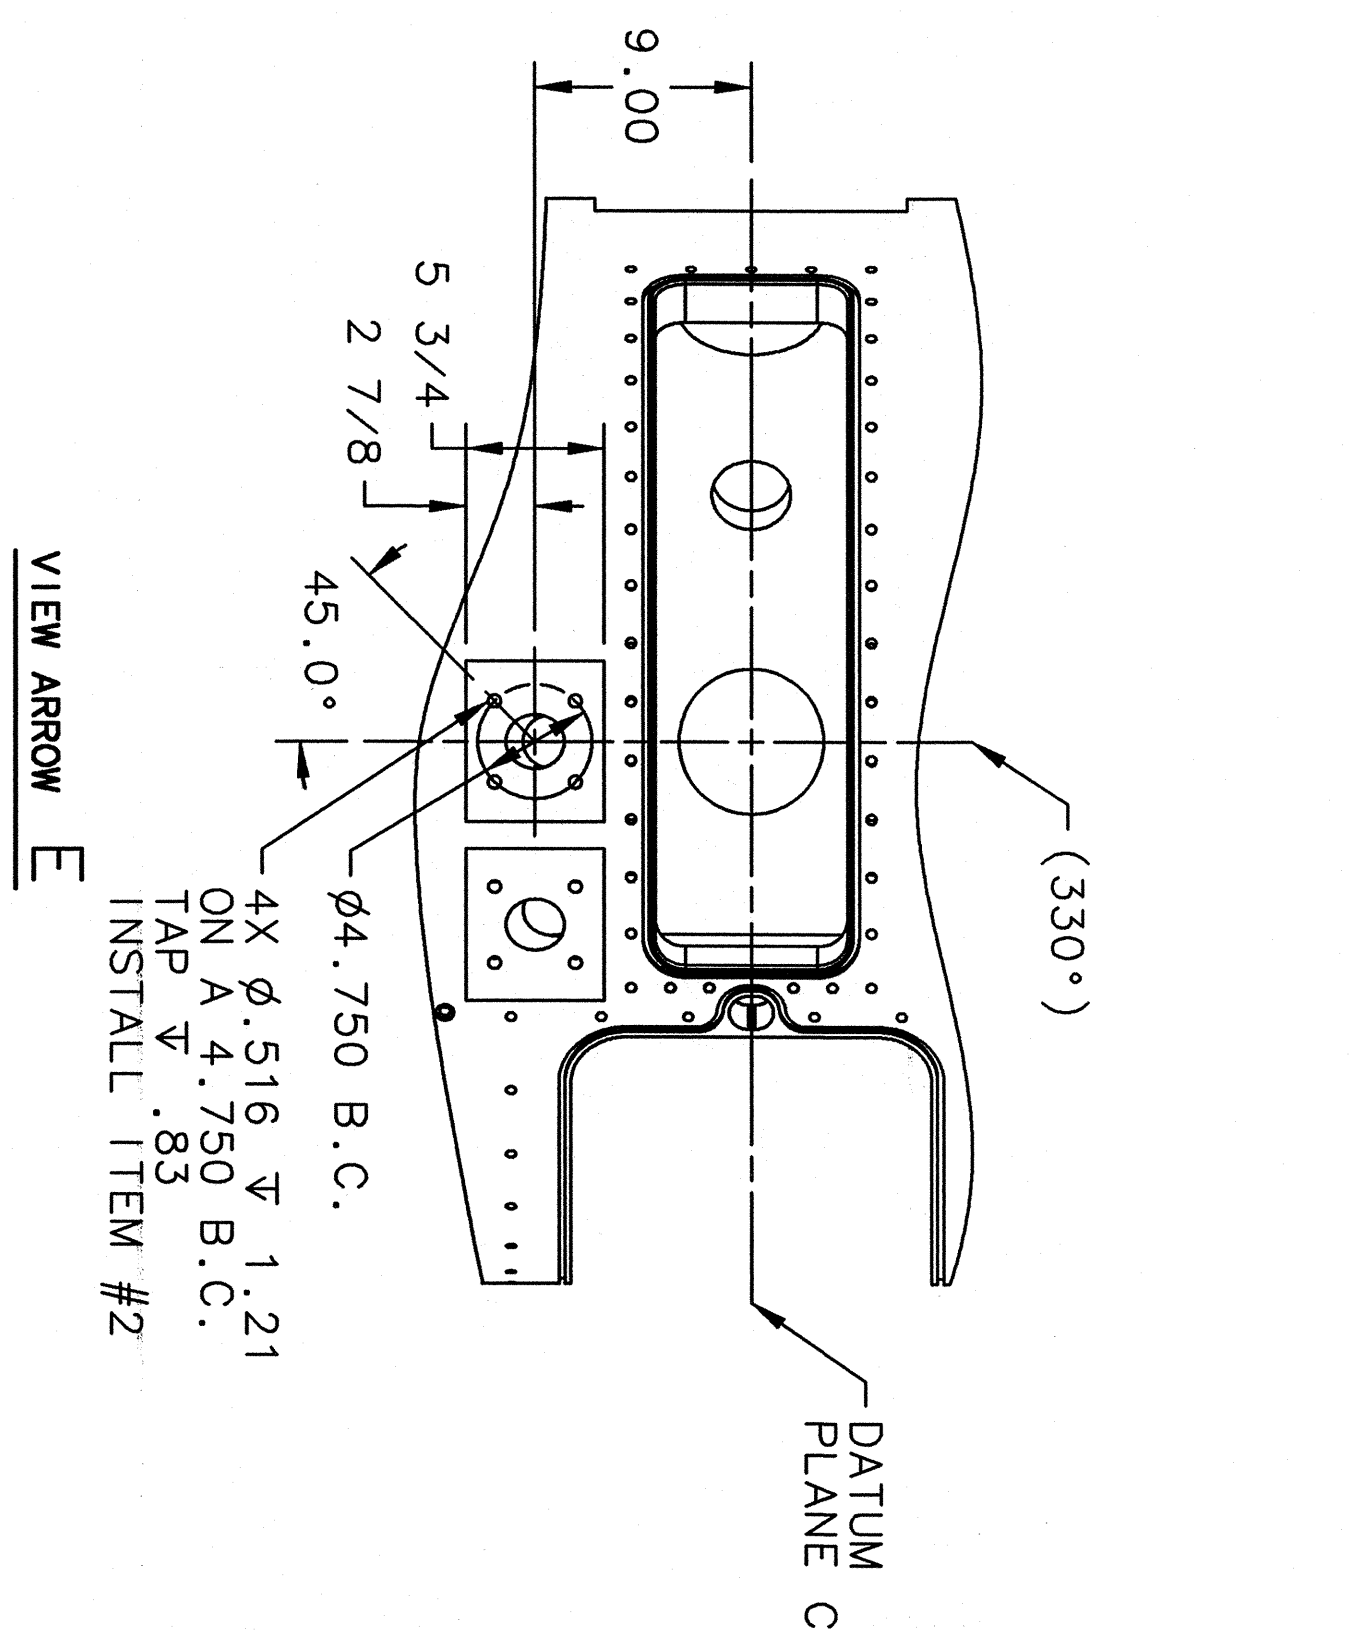


2 PLACES

2 PLACES

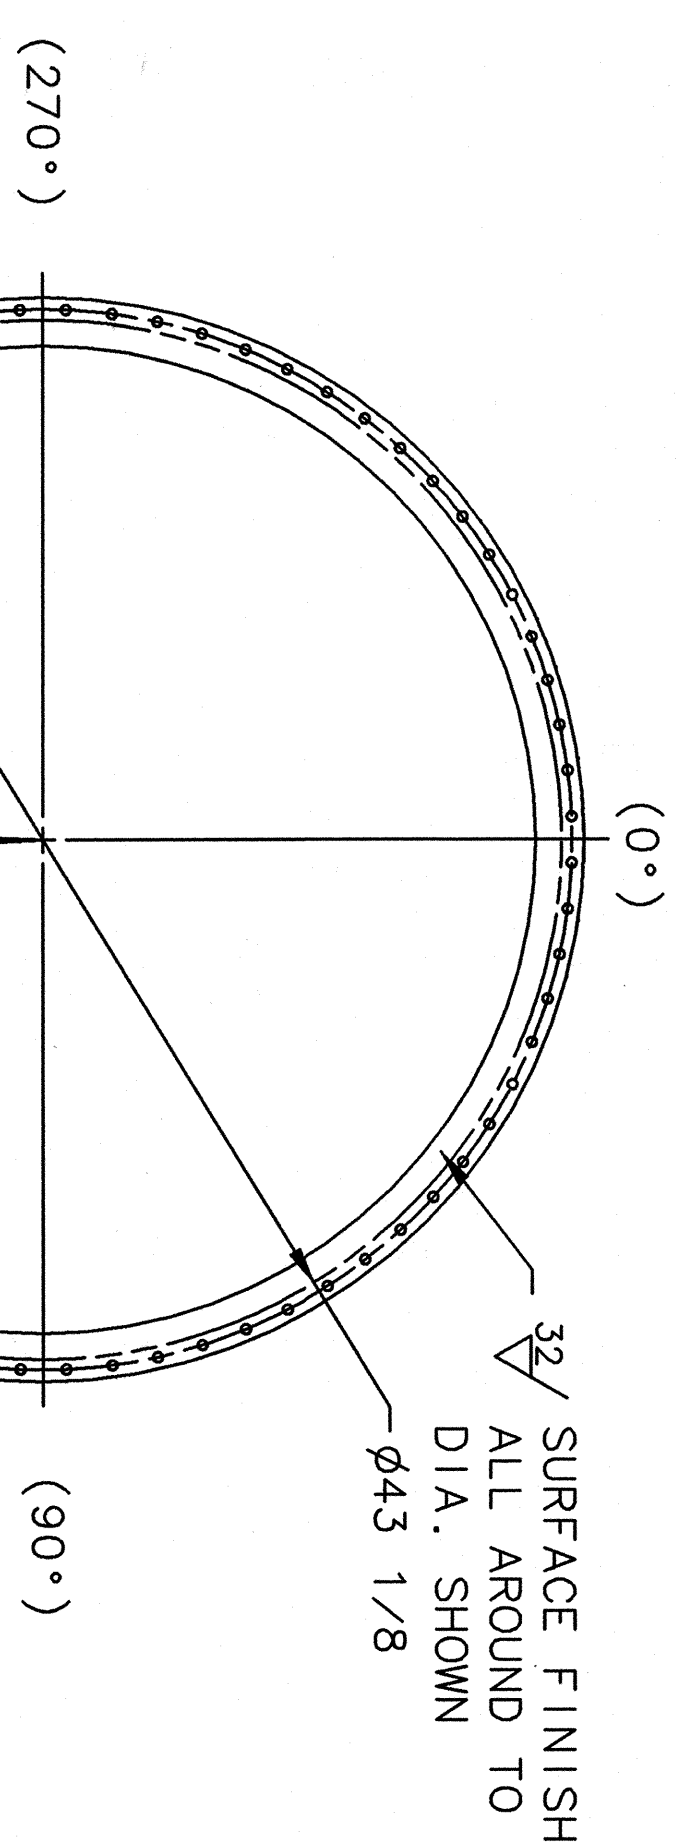


2/ .281±.001
GROOVE DEPT

SECTION A-A

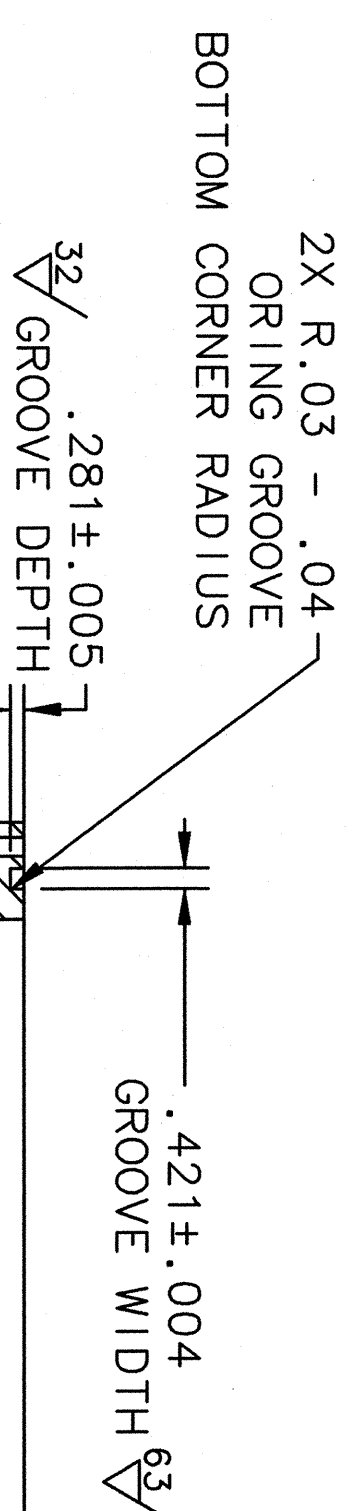



2X R.03 - .04-
ORING GROOVE
CORNER RADIUS
32/ .281±.003
▽ GROOVE DEPT


— .421±.004
GROOVE WIDTH ∇_{63}

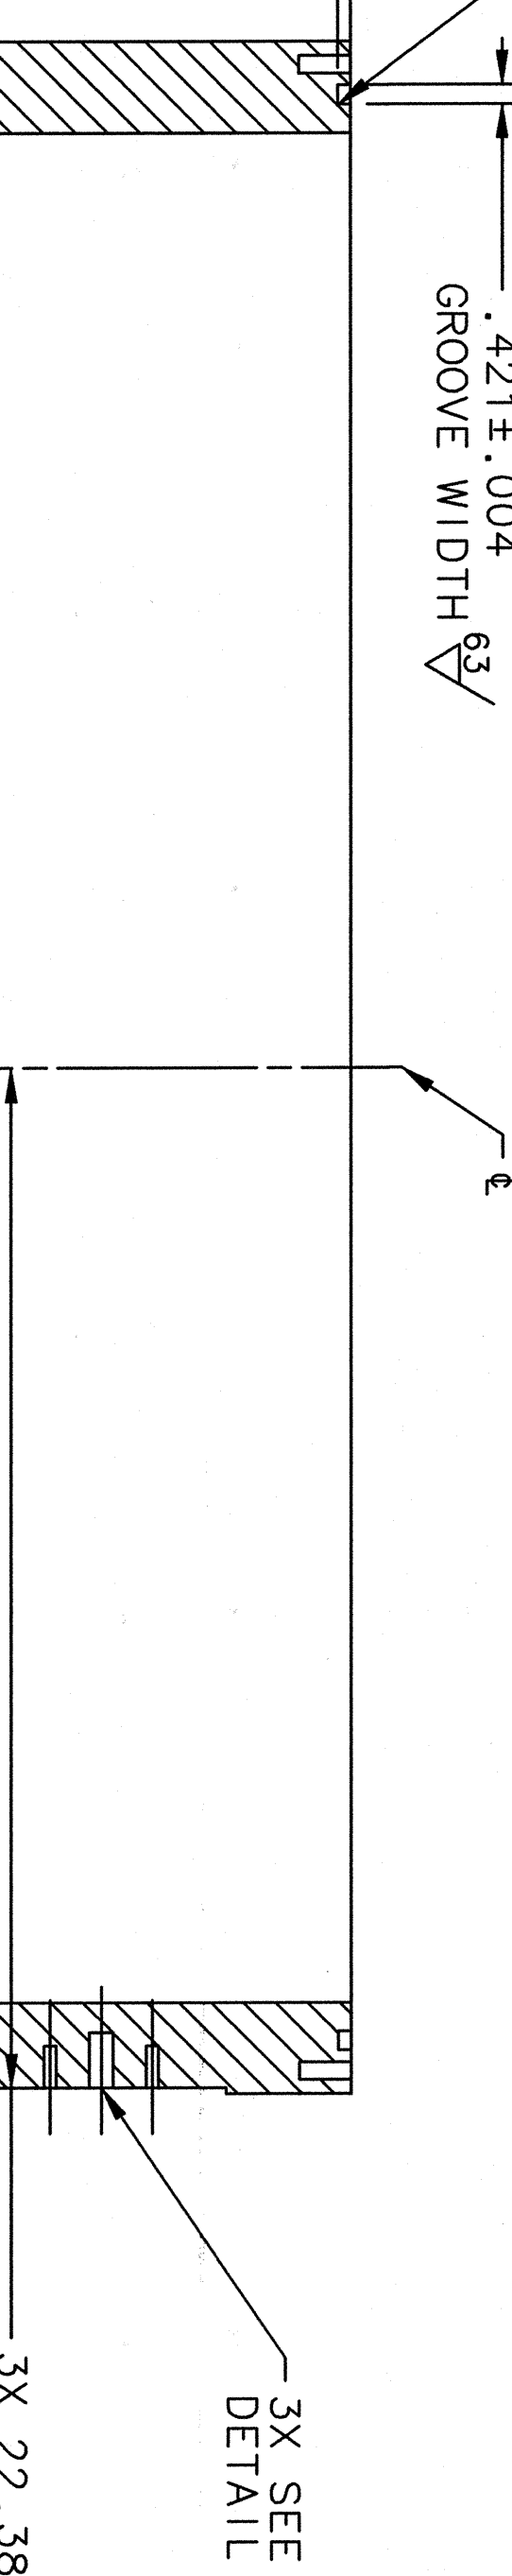

238

APPROVALS	DATE
JIM DAHLBERG	6-29-0
MIKE SEELY	6-29-0
ROLF ENT	6-29-0
STEVEN LASSITER	7-5-06

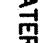DOCUMENT CONTROL STAMP	
MATERIAL	2219-T6 ALUMINUM (SCOT FORCE)
FINISH	63
MACHINED SURFACES	 UN ESSED OTHERWISE NOTED
DEBURR & BREAK ALL SHARP EDGES	
DO NOT SCALE DRAWING	

	<p> DIM & TO. PER ASSN Y14.5 UNLESS OTHERWISE SPECIFIED DIMENSIONS ARE IN INCHES TOLERANCES ARE: FRACTIONS DECIMAL $\pm 1/32$ $\times \pm .01$ $\times \pm .005$ ANGLES $\pm .2$ </p>
<p>THIRD ANGLE PROJECT 100</p>	

TRACKING NO.	
67150	
67153	
APPROVALS	DATE/TIME
DRAWN METZGER	6-29-0
CHECKED PAULO MEDEIROS	6-29-0
APPROVED MIKE FOMER	6-29-0
APPROVED PAUL BERNINZA	6-29-0

76153-E-56003 67153-0002 SHEET 1 OF 3		SIZE DWG. NO. 1/8	PART C
SCATTERING CHAMBER FORGED RING			
HALL C			
THOMAS JEFFERSON NATIONAL ACCELERATOR FACILITY UNITED STATES DEPARTMENT OF ENERGY			

NOTES

- 1: MATERIAL IS 2219-T6 ALUMINUM WITH A MINIMUM 58 KSI TENSILE 40 KSI YIELD STRENGTH. ALL SURFACES ARE MACHINED TO FINISH. PROVIDE BY SCOT FORGE 1-800-435-6621.
- 2: 2 PLACE TOLERANCE FOR THIS DIMENSION.
- 3: 3D MODEL CAN BE PROVIDED TO ASSIST MANUFACTURE (DOVETAIL ANGLE IN ORING GROOVE NOT MODELED).
- 4: DRAWINGS TAKE PRECEDENCE OVER 3D MODELS.
- 5: SOME OBJECT LINES REMOVED FOR CLARITY.
- 6: HELIUM MASS SPECTROMETER VACUUM LEAK TEST MINIMUM SENSITIVITY OF (1X10E-9 SCC/SEC) NO DETECTABLE LEAK IS ALLOWED SEE LEAK CHECK ASSEMBLY 67153--56009.

2: > 2 PLACE TOLERANCE FOR THIS DIMENSION

3: 3D MODEL CAN BE PROVIDED TO ASSIST MANUFACTURE (DOVETAIL ANGLE IN ORING GROOVE NOT MODELED).

4: DRAWINGS TAKE PRECEDENCE OVER 3D MODELS

5: SOME OBJECT LINES REMOVED FOR CLARITY

6: HELIUM MASS SPECTROMETER VACUUM LEAK TEST

LEAK CHECK ASSEMBLY 67153-56009.

[illegible][illegible]